


EN	REV	DESCRIPTION	BY	DATE
17-022	A	INITIAL RELEASE	EF	4/04/18
19-008	B	SEE ECN 19-008	EF	1/28/19

- NOTES:
1. WIRE GAGES SHOWN ABOVE ARE MINIMUM WIRE SIZES
 2. WIRES TO BE AWG 22 MINIMUM UNLESS OTHERWISE SPECIFIED
 3. IF POSSIBLE REPLACE EXISTING AIR CONDITIONER CIRCUIT BREAKER IN CIRCUIT BREAKER PANEL ASSEMBLY WITH P/N: T277-2-1 CIRCUIT BREAKER, OTHERWISE PLACE IN AN UNUSED BAY OF SAME PANEL ASSEMBLY AND LABEL

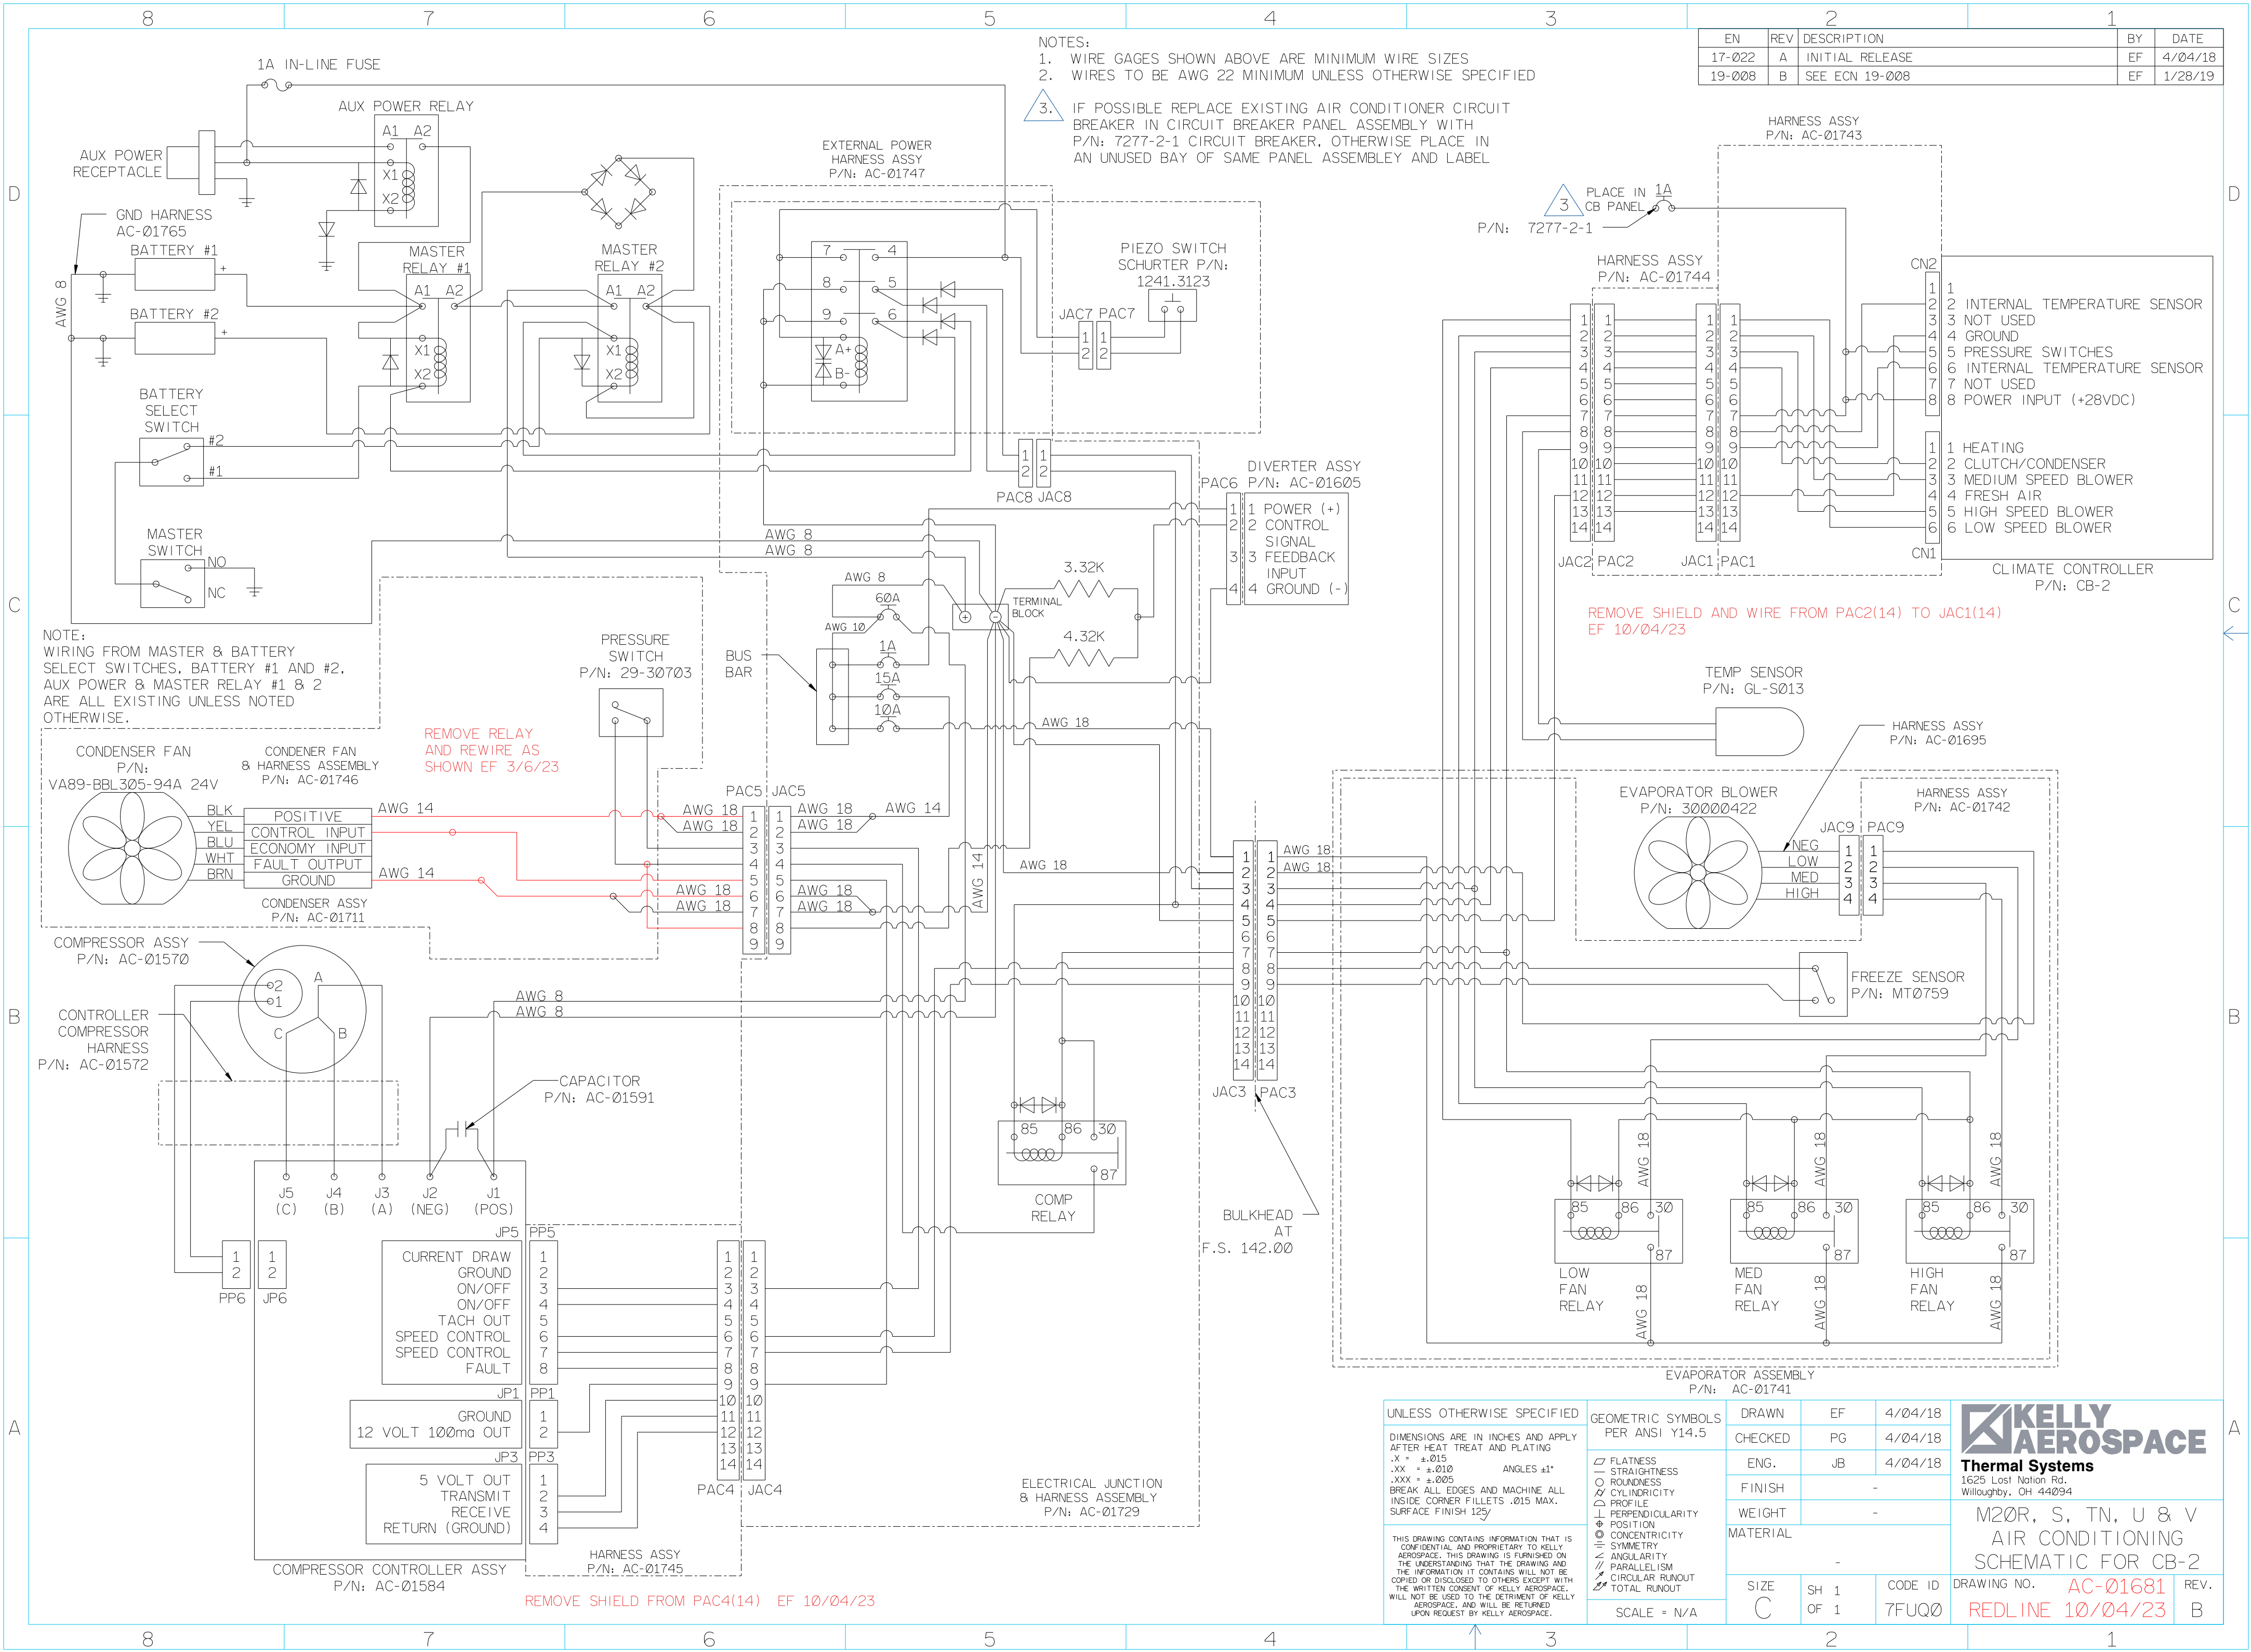

NOTE:
WIRING FROM MASTER & BATTERY SELECT SWITCHES, BATTERY #1 AND #2, AUX POWER & MASTER RELAY #1 & 2 ARE ALL EXISTING UNLESS NOTED OTHERWISE.

REMOVE RELAY AND REWIRE AS SHOWN EF 3/6/23

REMOVE SHIELD AND WIRE FROM PAC2(14) TO JAC1(14) EF 10/04/23

REMOVE SHIELD FROM PAC4(14) EF 10/04/23

UNLESS OTHERWISE SPECIFIED		DRAWN		DATE	
DIMENSIONS ARE IN INCHES AND APPLY AFTER HEAT TREAT AND PLATING		EF	4/04/18	 1625 Last Nation Rd. Willoughby, OH 44094	
.X = ±.015		PG	4/04/18		
.XX = ±.010		JB	4/04/18		
.XXX = ±.005		FINISH	-	M20R, S, TN, U & V AIR CONDITIONING SCHEMATIC FOR CB-2	
BREAK ALL EDGES AND MACHINE ALL INSIDE CORNER FILLETS .015 MAX. SURFACE FINISH 125		WEIGHT	-	DRAWING NO. AC-01681	
THIS DRAWING CONTAINS INFORMATION THAT IS CONFIDENTIAL AND PROPRIETARY TO KELLY AEROSPACE. THIS DRAWING IS FURNISHED ON THE UNDERSTANDING THAT THE DRAWING AND THE INFORMATION IT CONTAINS WILL NOT BE COPIED OR DISCLOSED TO OTHERS EXCEPT WITH THE WRITTEN CONSENT OF KELLY AEROSPACE. IT WILL NOT BE USED TO THE DETRIMENT OF KELLY AEROSPACE, AND WILL BE RETURNED UPON REQUEST BY KELLY AEROSPACE.		MATERIAL	-	REV. B	
		SIZE	SH 1 OF 1	CODE ID	7FUQ0
				DRAWING NO.	AC-01681
				REDLINE	10/04/23
				SCALE	N/A